

# Public Notice

**US Army Corps  
of Engineers**  
Louisville District ®

Public Notice No.  
LRL-2013-533-pgj

Open Date:  
12 Aug 2014

Close Date:  
11 Sep 2014

Please address all comments and inquiries to:

U.S. Army Corps of Engineers, Louisville District

ATTN: Patricia A. Grace-Jarrett, Ph. D., CELRL-OP-FS, Rm 752

P.O. Box 59

Louisville, Kentucky 40201-0059

Phone: 502-315-6687

This notice announces a proposal to revise the proposed service area for the Richards Property Stream Mitigation Bank. The Richards Property Mitigation Bank has been submitted in accordance with the "Compensatory Mitigation for Losses of Aquatic Resources" (Mitigation Rule)(CFR Vol. 73 No. 70, p 19670-19705 (33 U.S.C. 401 *et seq.*; 33 U.S.C. 1344; and Pub. L. 108-136), as published in the federal register on April 10, 2008, and is currently under review:

SPONSOR: The Nature Conservancy - Kentucky Chapter  
114 Woodland Avenue  
Lexington, Kentucky 40502

AGENT: Redwing Ecological Services, Inc.  
1139 South Fourth Street  
Louisville, Kentucky 40203

LOCATION: Streams on a 338-acre property located approximately 0.8 mile south of the intersection of South Dividing Ridge Road and Kentucky Highway 32 near Sadieville, Scott and Harrison Counties, Kentucky.

Latitude: 38.36037 W  
Longitude: -84.46765 N

7.5 Minute Quad: Breckinridge, Delaplain and Leesburg

PURPOSE: To develop a stream mitigation bank in the lower Kentucky River Basin.

DESCRIPTION: A public notice was issued on September 30, 2013, regarding the proposed construction of a stream mitigation bank known as the "Richards Property Stream Mitigation Bank". That proposal included a prospectus, which specified the Service Area as consisting of the portion of the Lower Kentucky River Watershed (8-digit hydrologic unit code, HUC: 05100205) within the Interior Plateau Level III Ecoregion (Figure 1). The Sponsor has requested a change to the

proposed service area to include five, 12-digit HUCs (051401010301, 051401010302, 051401010303, 051401010304, and 051401010305) within the Corn Creek-Ohio River Watershed. The Corn Creek-Ohio River Watershed (HUC: 0514010106) is within the same Level III Ecoregion but is not within the Lower Kentucky River Watershed. The Sponsor proposes to reduce the previously proposed Service Area through the removal of a portion (HUCs 051002050401, 051002050402, and 051002050403) of the Upper Dix River Watershed (HUC 0510020504) (Figure 2). No other changes to the original proposal, as contained in the submitted prospectus and public notice, dated September 30, 2013, have been requested.

**PUBLIC REVIEW AND COMMENT:** The Corps of Engineers is soliciting comments from the public; Federal, State, and local agencies and officials; Indian tribes; and other interested parties in order to consider and evaluate this proposal. It is presumed that all interested parties and agencies will respond; therefore, a lack of response will be interpreted as meaning that there is no objection to the proposal.

Written statements received in this office on or before the closing date will become a part of the official record and will be considered in the determination for this proposal. Any objections which are received during this period will be forwarded to the applicant for possible resolution before the determination is made whether to approve the Richards Property Stream Mitigation Bank.

Information pertaining to this proposal is available for public examination during normal business hours upon prior request. Drawings are available on Louisville District's Internet site at <http://www.lrl.usace.army.mil/Missions/Regulatory.aspx>. All comments regarding this proposal should be addressed to Patricia A. Grace-Jarrett, Ph. D., CELRL-OP-FS at the address noted above and should refer to the Public Notice Number LRL-2013-533-pgj.

If you desire to submit your comments by email, you must comply with the following:

a) In the subject line of your email, type in **ONLY** the Public Notice ID No. LRL-2013-533-pgj.

Example:


Subject: LRL-2013-533-pgj

b) Provide your physical mailing address and telephone number.

c) Send your email to: [lrl.regulatorypubliccomment@usace.army.mil](mailto:lrl.regulatorypubliccomment@usace.army.mil).

d) If you are sending attachments greater than 1 Mb in size with your email, you must send a hard copy (CD or paper) to the Corps' physical address as well.

Source: River Basin and County Basefiles from Kentucky Geological Survey; Rivers, Streams, and Interstate Highway Basefiles from ESRI

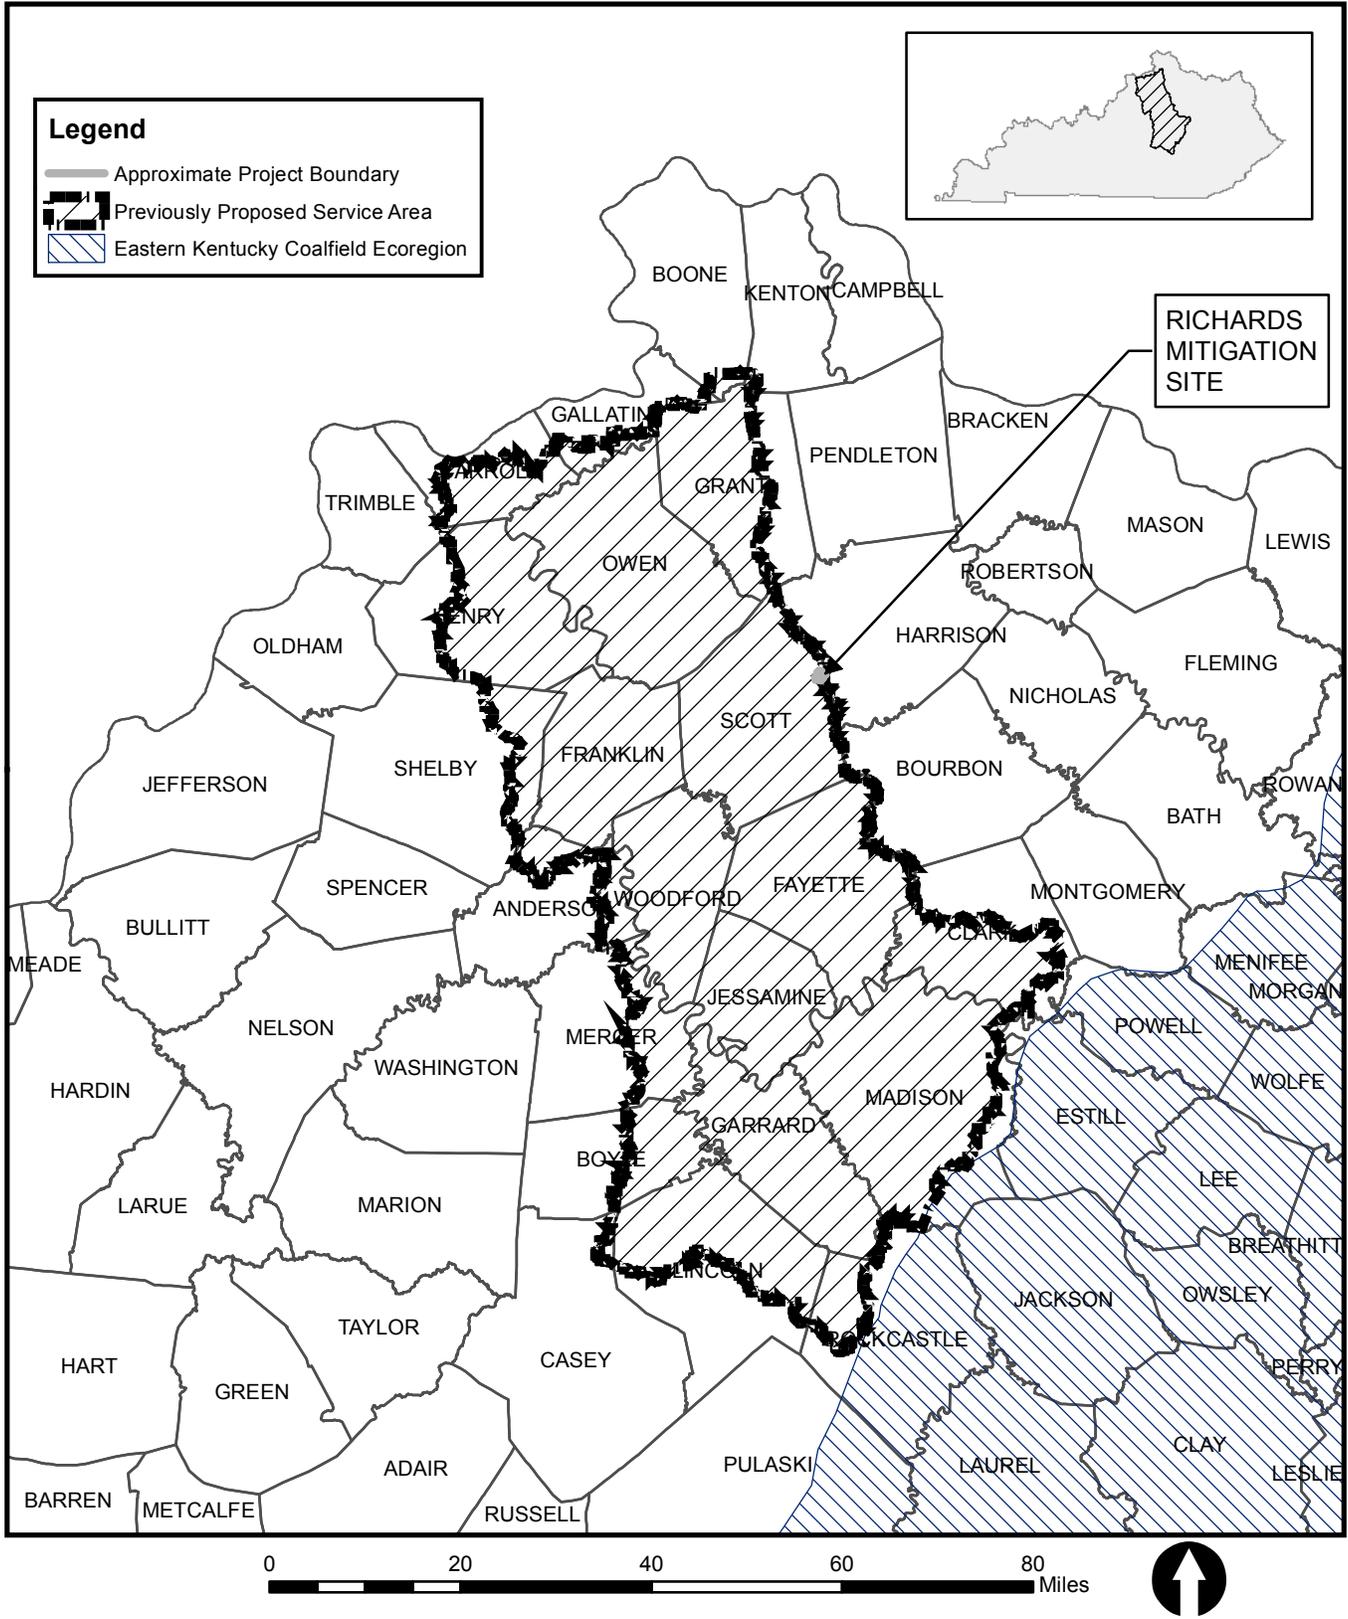

P:\2013 Projects\13-003-RichardsStreamBank\Figures\PublicNotice\_2014\OriginalServiceArea.mxd, 07-31-2014, temp


RICHARDS PROPERTY  
MITIGATION BANK  
SCOTT AND HARRISON COUNTIES,  
KENTUCKY

REVISED DATE: 07-30-14 | DRAWN BY: EDB/RSC



PREVIOUSLY PROPOSED  
SERVICE AREA  
(USACE ID No. LRL-2013-533-pgj)

FIGURE 1

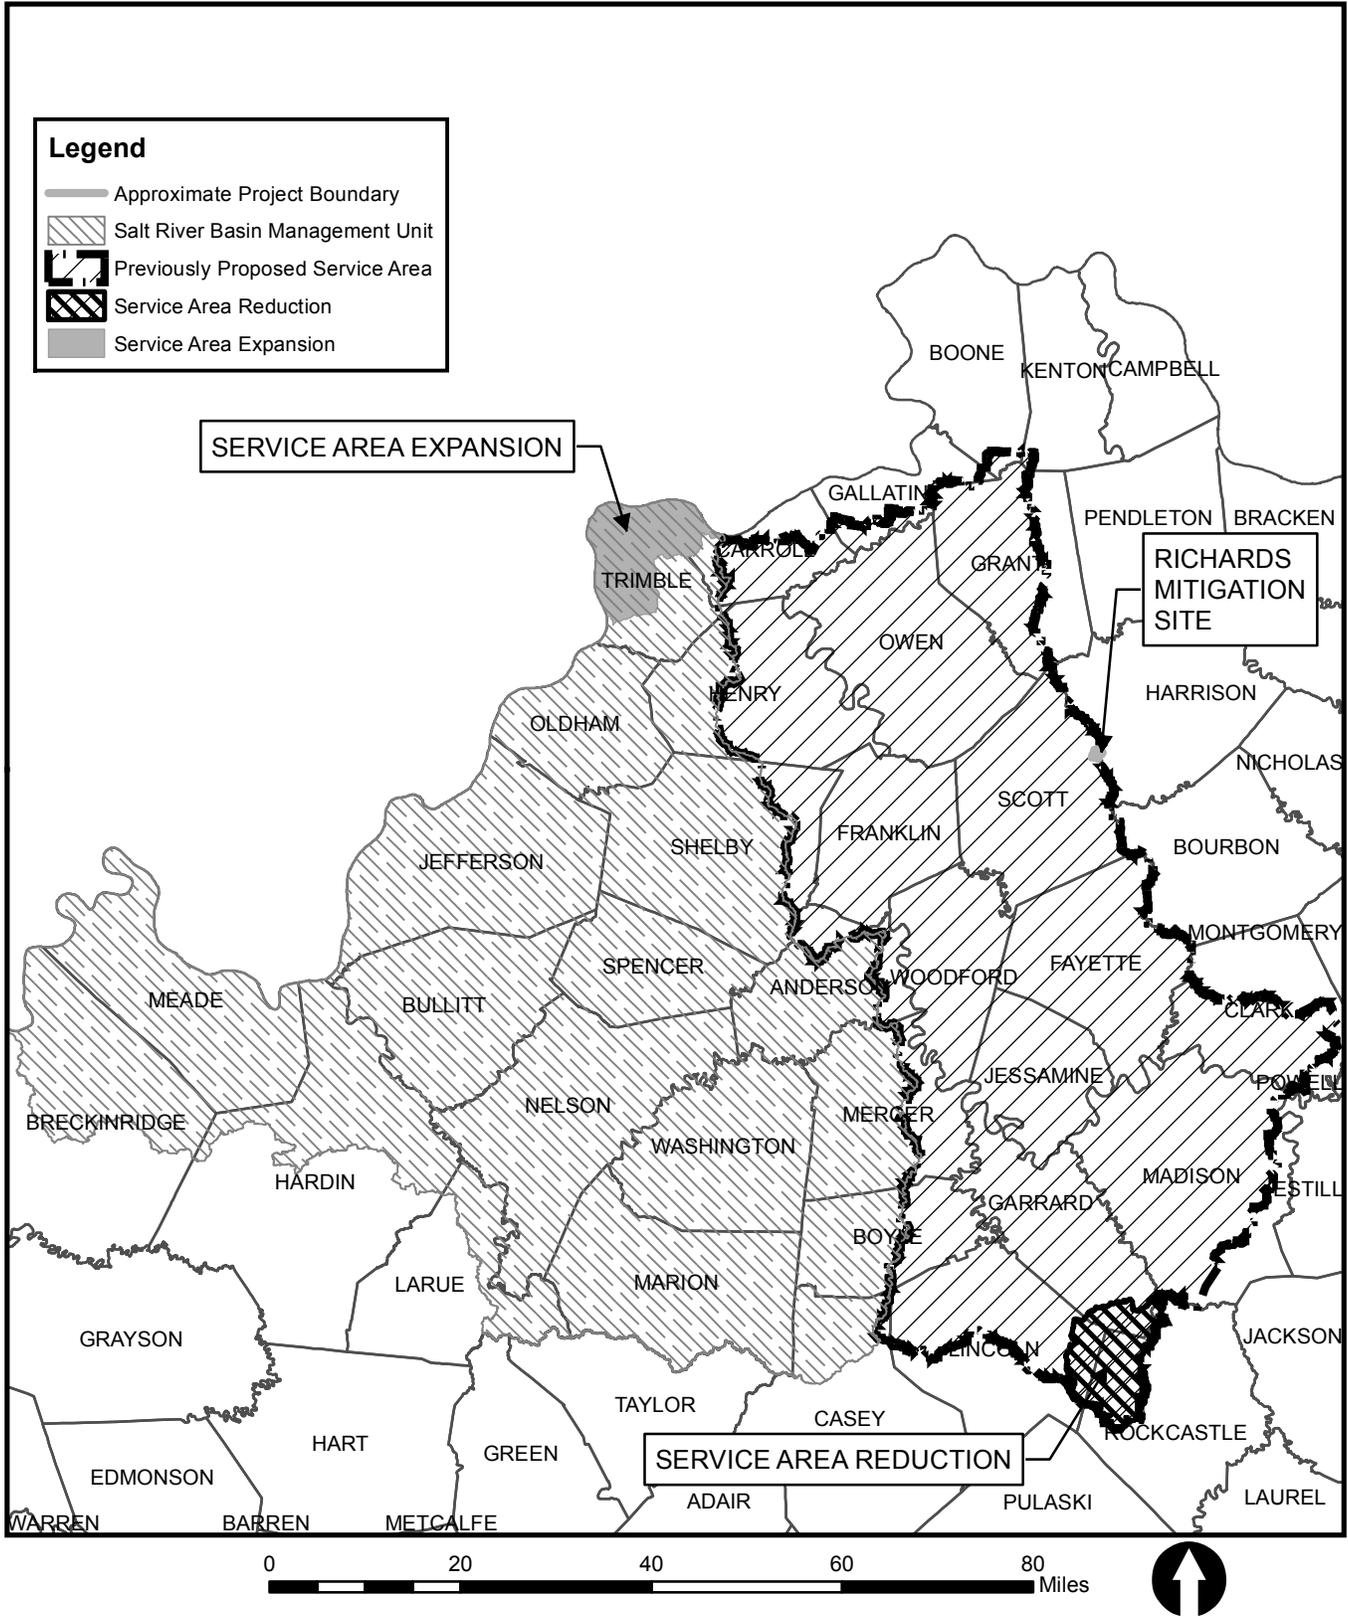

P:\2013 Projects\13-003-RichardsStreamBank\Figures\PublicNotice\_2014\ProposedServiceArea.mxd, 07-31-2014, temp

RICHARDS PROPERTY  
MITIGATION BANK  
SCOTT AND HARRISON COUNTIES,  
KENTUCKY



PROPOSED  
SERVICE AREA  
(USACE ID No. LRL-2013-533-pgj)